

WILDLIFE AND COUNTRYSIDE ACT 1981

THE NOTTINGHAMSHIRE (AREA 3) DEFINITIVE MAP AND STATEMENT

THE NOTTINGHAMSHIRE COUNTY COUNCIL
(CARLTON RESTRICTED BYWAY NO. 46 AND BRIDLEWAY NO. 47)
Footpath MODIFICATION ORDER 2015

This Order is made by the Nottinghamshire County Council under Section 53(2)(b) of the Wildlife & Countryside Act 1981 ("the Act") because it appears to that Authority that the Nottinghamshire (Area 3) Definitive Map and Statement require modification in consequence of the occurrence of an event specified in Section 53 (3) (c) (i) of the Act, namely the discovery of evidence that rights of way subsist or are reasonably alleged to subsist over land situated at Carlton.

The Authority have consulted with every Local Authority whose area includes the land to which the Order relates.

The Nottinghamshire County Council hereby order that:

1. For the purposes of this Order the relevant date is 1st April 2015.
2. The Nottinghamshire (Area 3) Definitive Map and Statement shall be modified as described in Part I and Part II of the Schedule and shown on the Map attached to this Order.
3. This Order shall take effect on the date it is confirmed and may be cited as "The Nottinghamshire County Council (~~Carlton Restricted Byway No. 46 and Bridleway No. 47~~) *Footpath* Modification Order 2015".

SCHEDULE

PART I

Modification of Definitive Map

Description of the Paths or Ways to be added

Footpath
Carlton Restricted Byway No. 46

Commencing from a point, SK 59144248, at the junction with Lees Road and proceeding ~~for a distance of approximately 235 metres in a south-easterly then south-westerly direction to a point, SK 59114231, at the junction with Porchester Road and having a width of 207 metres throughout the whole of its length.~~

Carlton Bridleway No. 47

direction to a point, SK 5927 4238, at the junction with Kenrick Road and having a width of 2.7 metres between SK 5914 4248 and SK 5921
Commencing from a point, SK 59214243, at the junction with Carlton Restricted Byway No. 46 and proceeding for a distance of approximately 68 metres in a south-easterly direction to a point, SK 59274238, at the junction with Kenrick Road and having a width of 2.4 metres throughout the whole of its length.

4243 and a width of 2.4 metres between SK 5924 1243 and SK 5927 4238



**Nottinghamshire
County Council**

**Proposed
Modification Order**

Parish and Path No. Affected: *Footpath* Carlton Restricted Byway No. 46
and Bridleway No. 47

OS Sheet No. SK 54 SE



Footpath

Bridleway

Date 12/03/2015 Scale 1:2,500

Byway Open to All Traffic

Restricted Byway

Produced by David Squires

Connecting paths

© Crown Copyright and database rights 2015 Ordnance Survey 100019713

342600m

SK 5914 4248

SK 5921 4243

Footpath
**Restricted
Byway No. 46**

**Bridleway
No. 47**

342400m

SK 5927 4238


SK 5911 4231

342200m

459000m

459200m

459400m

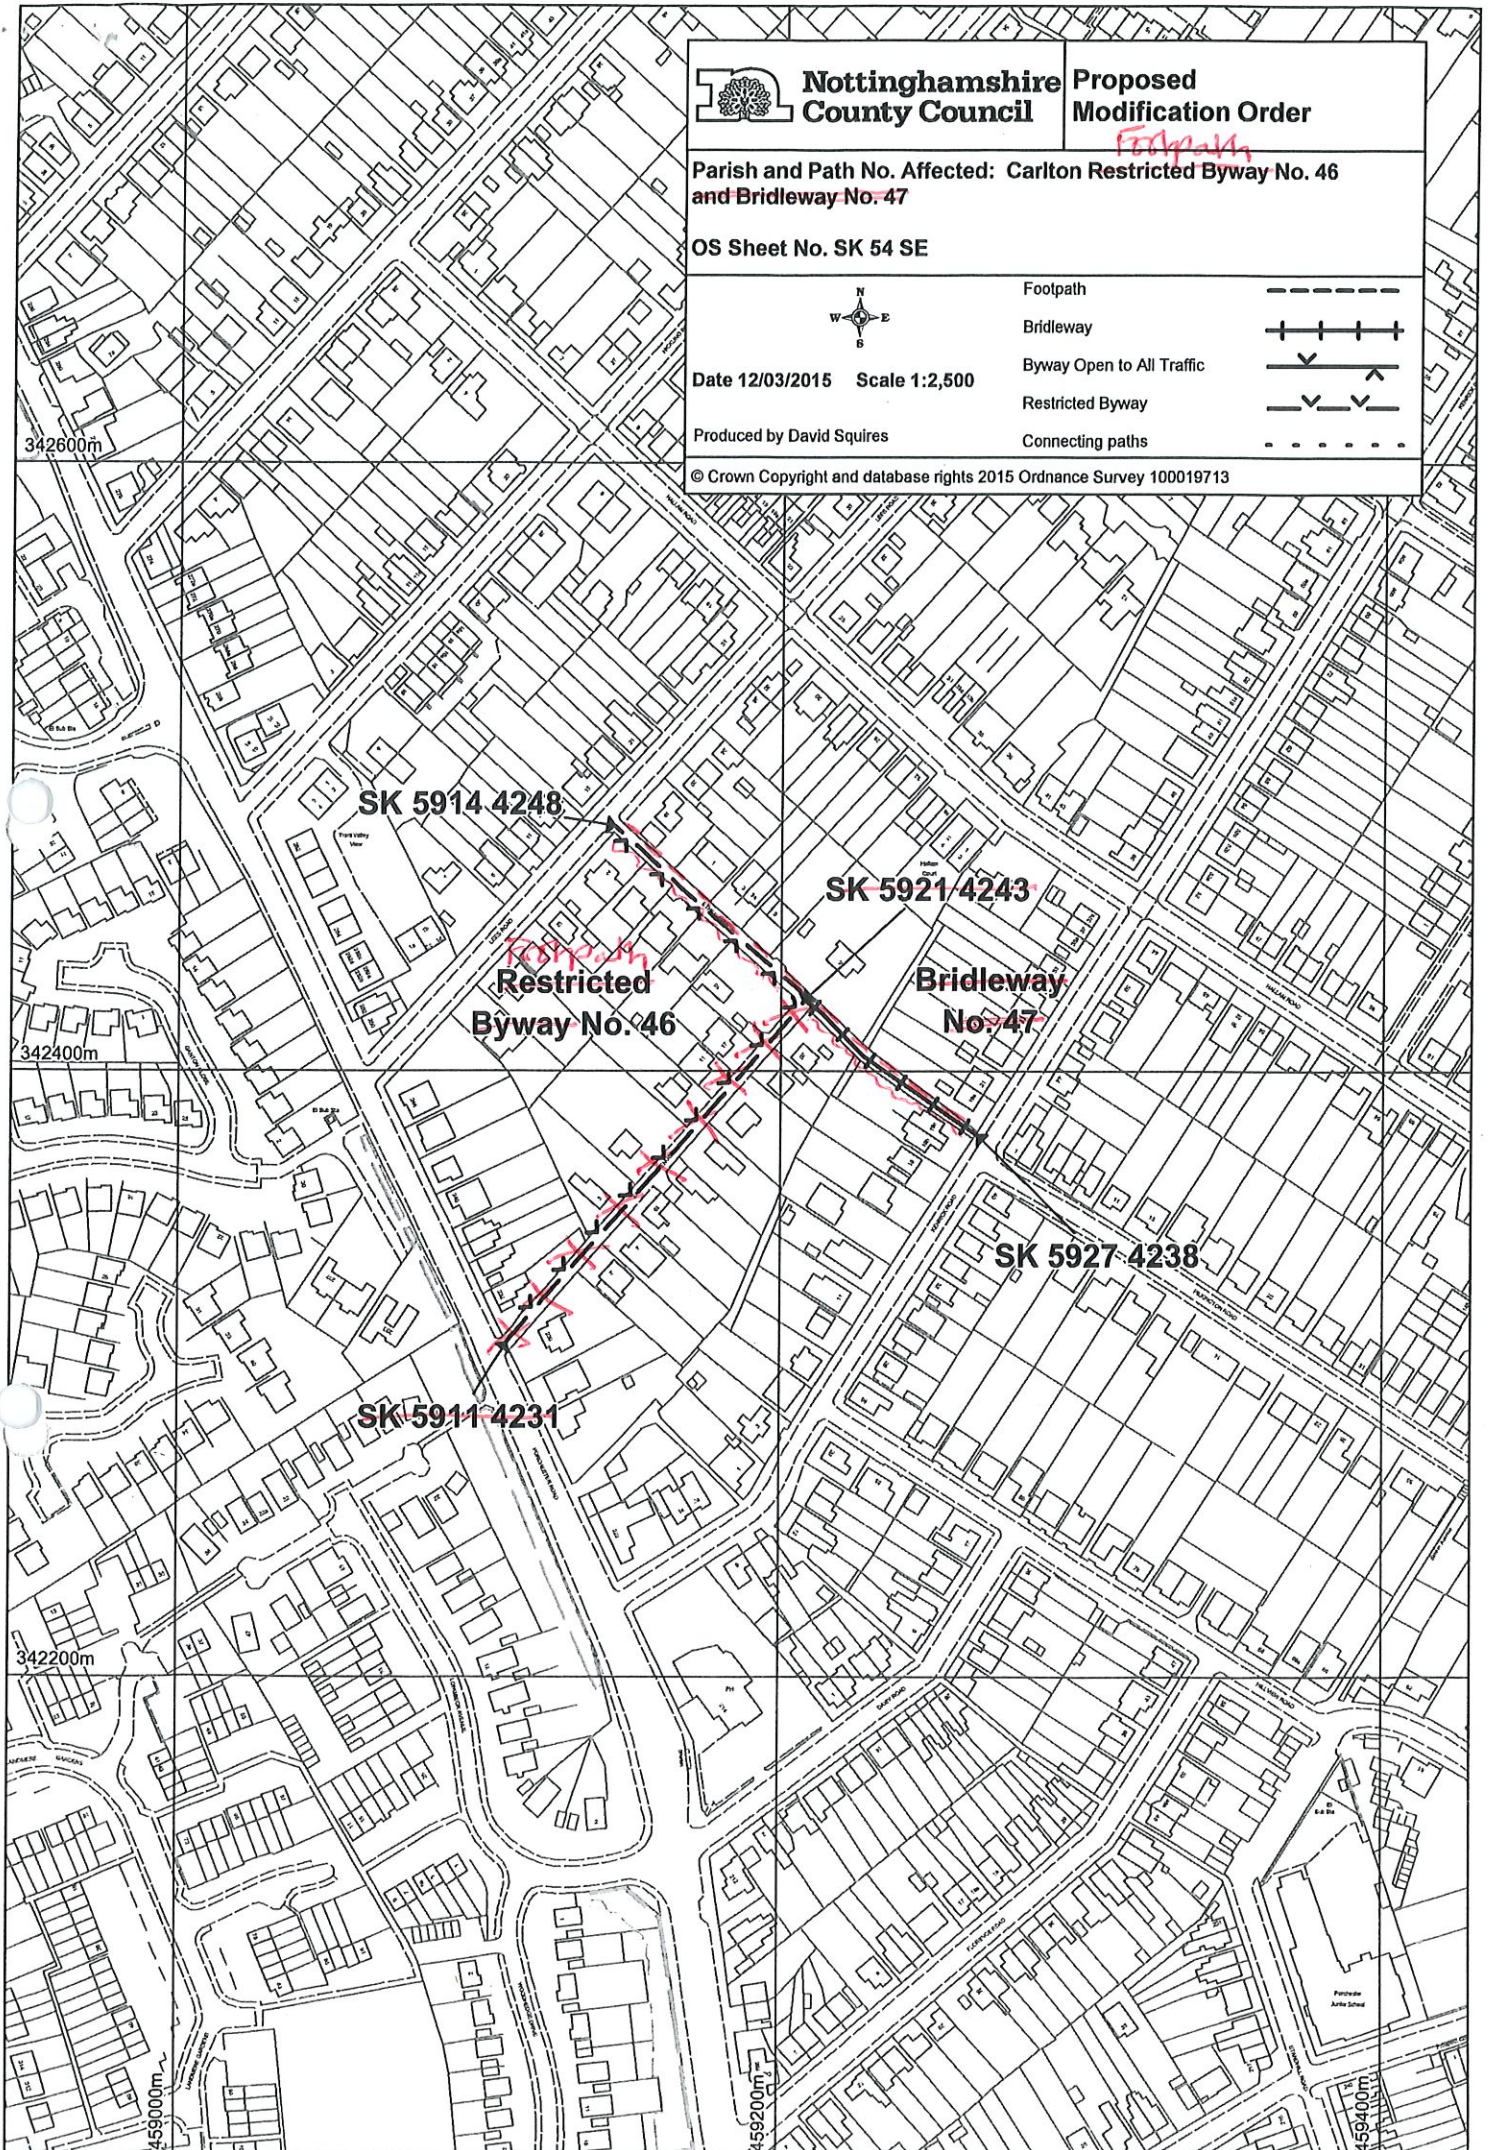

THE NOTTINGHAMSHIRE COUNTY COUNCIL
(CARLTON RESTRICTED BYWAY NO. 46 AND BRIDLEWAY NO. 47)
Footpath MODIFICATION ORDER 2015

PART II

Modification of Definitive Statement

Description of the Paths or Ways to be added

Footpath
Carlton Restricted Byway No. 46

Commencing from a point, SK 59144248, at the junction with Lees Road and proceeding ~~for a distance of approximately 235 metres~~ in a south-easterly, then south-westerly direction on the ~~metalled surfaces of Ethel Avenue and Emmanuel Avenue~~ to a point, SK 59114231, at the junction with Porchester Road and having a width of 2.7 metres throughout the whole of its length.

direction to a point, SK 5921 4238 at the junction with Kennick Road, having a metalled surface and width of 2.7 metres between SK 5914 4248 and SK 5921
Carlton Bridleway No. 47

Commencing from a point, SK 59214243, at the junction with Carlton Restricted Byway No. 46 and proceeding for a distance of approximately 68 metres in a south-easterly direction on an earth and grass surface between property boundaries to a point, SK 59274238, at the junction with Kenrick Road and having a width of 2.4 metres throughout the whole of its length.

THE COMMON SEAL of THE
NOTTINGHAMSHIRE COUNTY COUNCIL

was hereunto affixed

this 24th day of April 2015

in the presence of:-

SEAL REGISTER
NO. -

41656



4243 and an earth and grass surface and a width of 2.4 metres between SK 5921 4243 and SK 5927 4238.

Sue Beaman

AUTHORISED SIGNATORY

The foregoing order is hereby confirmed
subject to the red ink modifications thereon

Nigel Farthing . 5 JUL 2024

An Inspector appointed by The Secretary
of State for Environment, Food and
Rural Affairs